


<p>Project 項目名稱: Temporary Warehouse for Storage of Spare Parts and Adblue for a Period of 3 Years at Lots 1827 S.B (Part), 1827 S.B ss.1, 1828 (Part), 1843 (Part), 1844 (Part), 1845 (Part), 1846 (Part), 1848, 1849 (Part), in D.D. 125 and Adjoining Government Land, Ha Tsuen, Yuen Long, N.T.</p>	<p>Drawing Title 圖目: Site Plan</p> <p>Drawing No. 圖號: Figure 1</p>	<p>Remarks 備註:</p> <p>Scale 比例: 1:1000</p>
--	--	--



<p>Project 項目名稱: Temporary Warehouse for Storage of Spare Parts and Adblue for a Period of 3 Years at Lots 1827 S.B (Part), 1827 S.B ss.1, 1828 (Part), 1843 (Part), 1844 (Part), 1845 (Part), 1846 (Part), 1848, 1849 (Part), in D.D. 125 and Adjoining Government Land, Ha Tsuen, Yuen Long, N.T.</p>	<p>Drawing Title 圖目: Location Plan</p> <p>Drawing No. 圖號: Figure 2</p>	<p>Remarks 備註: ●●● Vehicular access leading to Ping Ha Road</p> <p>Scale 比例: 1:7500</p>
--	--	---

N

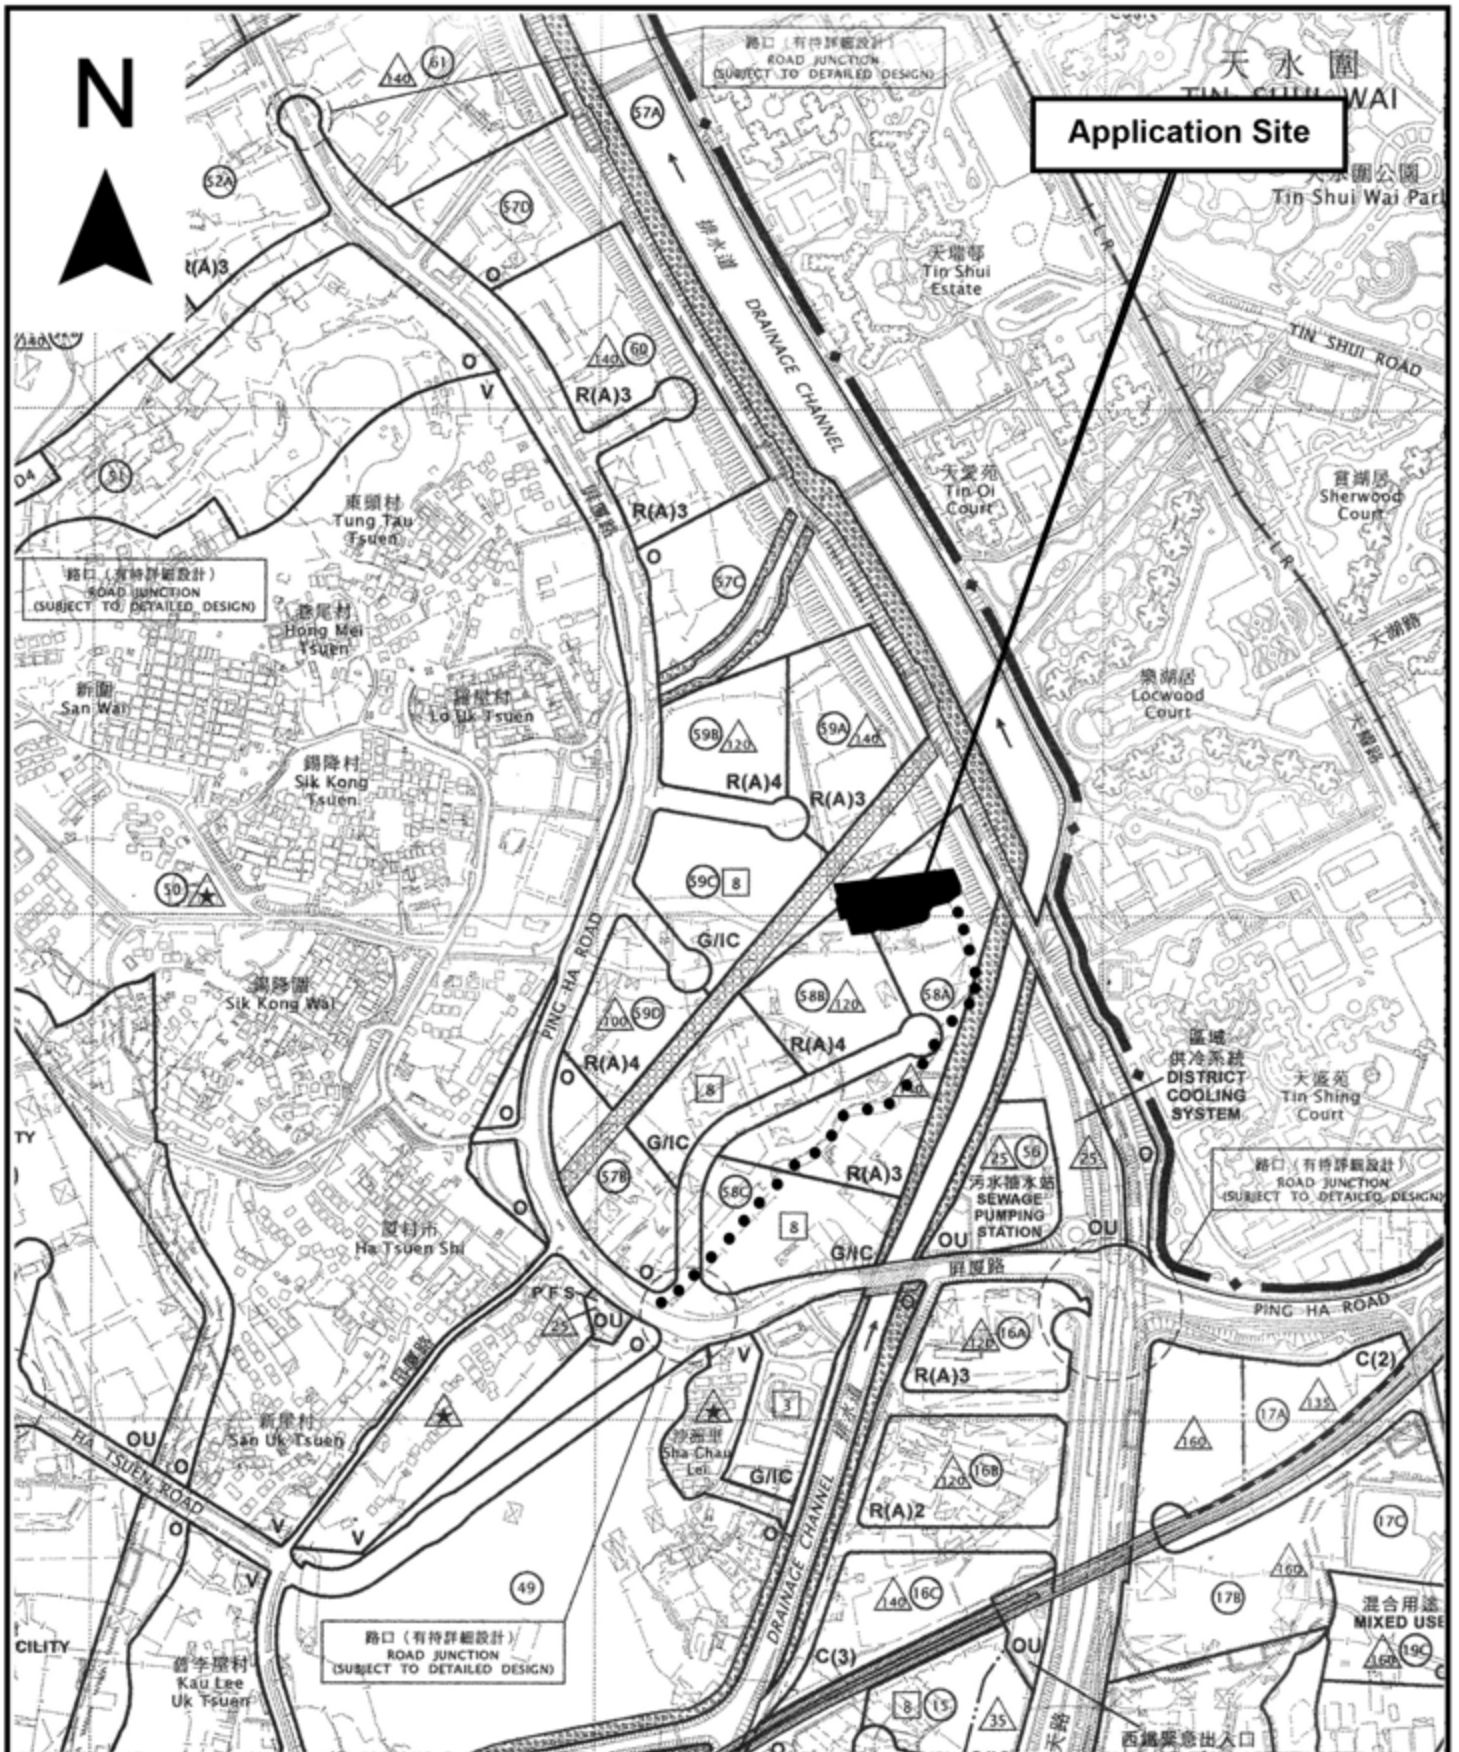

Structure 1

Warehouse for storage of spare parts and adblue
GFA: Not exceeding 3,560m²
(including rain shelter)
Height: Not exceeding 10m
No. of storey: 1

Structure 5

Site office and toilet under an open shed
GFA: Not exceeding 60m²
Height: Not exceeding 4m
No. of storey: 1

Structure 7

Site office
GFA: Not exceeding 60m²
Height: Not exceeding 4m
No. of storey: 1

Site office

2 loading/unloading bays of 11m x 3.5m for medium/heavy goods vehicle

Toilet

4 parking spaces of 5m x 2.5m for private car

Rain shelter

Structure 4

Water tank and pump room being part of fire service installations
GFA: Not exceeding 60m²
Height: Not exceeding 4.5m
No. of storey: 1

Structure 3

Toilet
GFA: Not exceeding 20m²
Height: Not exceeding 3.5m
No. of storey: 1

Structure 8


Electricity meter room
GFA: Not exceeding 6m²
Height: Not exceeding 3m
No. of storey: 1

Structure 2

Electricity meter room
GFA: Not exceeding 9m²
Height: Not exceeding 3m
No. of storey: 1

Structure 6

Guard room
GFA: Not exceeding 6m²
Height: Not exceeding 3m
No. of storey: 1

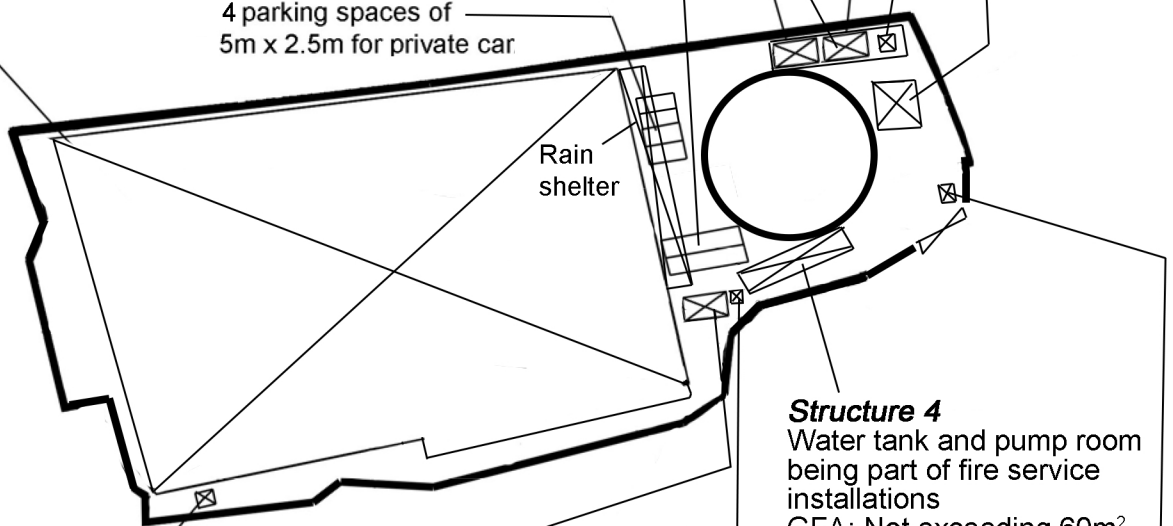

Project 項目名稱:

Temporary Warehouse for Storage of Spare Parts and Adblue for a Period of 3 Years at Lots 1827 S.B (Part), 1827 S.B ss.1, 1828 (Part), 1843 (Part), 1844 (Part), 1845 (Part), 1846 (Part), 1848, 1849 (Part), in D.D. 125 and Adjoining Government Land, Ha Tsuen, Yuen Long, N.T.

Drawing Title 圖目:

Proposed Layout Plan


Remarks 備註:

Drawing No. 圖號:

Figure 3

Scale 比例:

1:1000

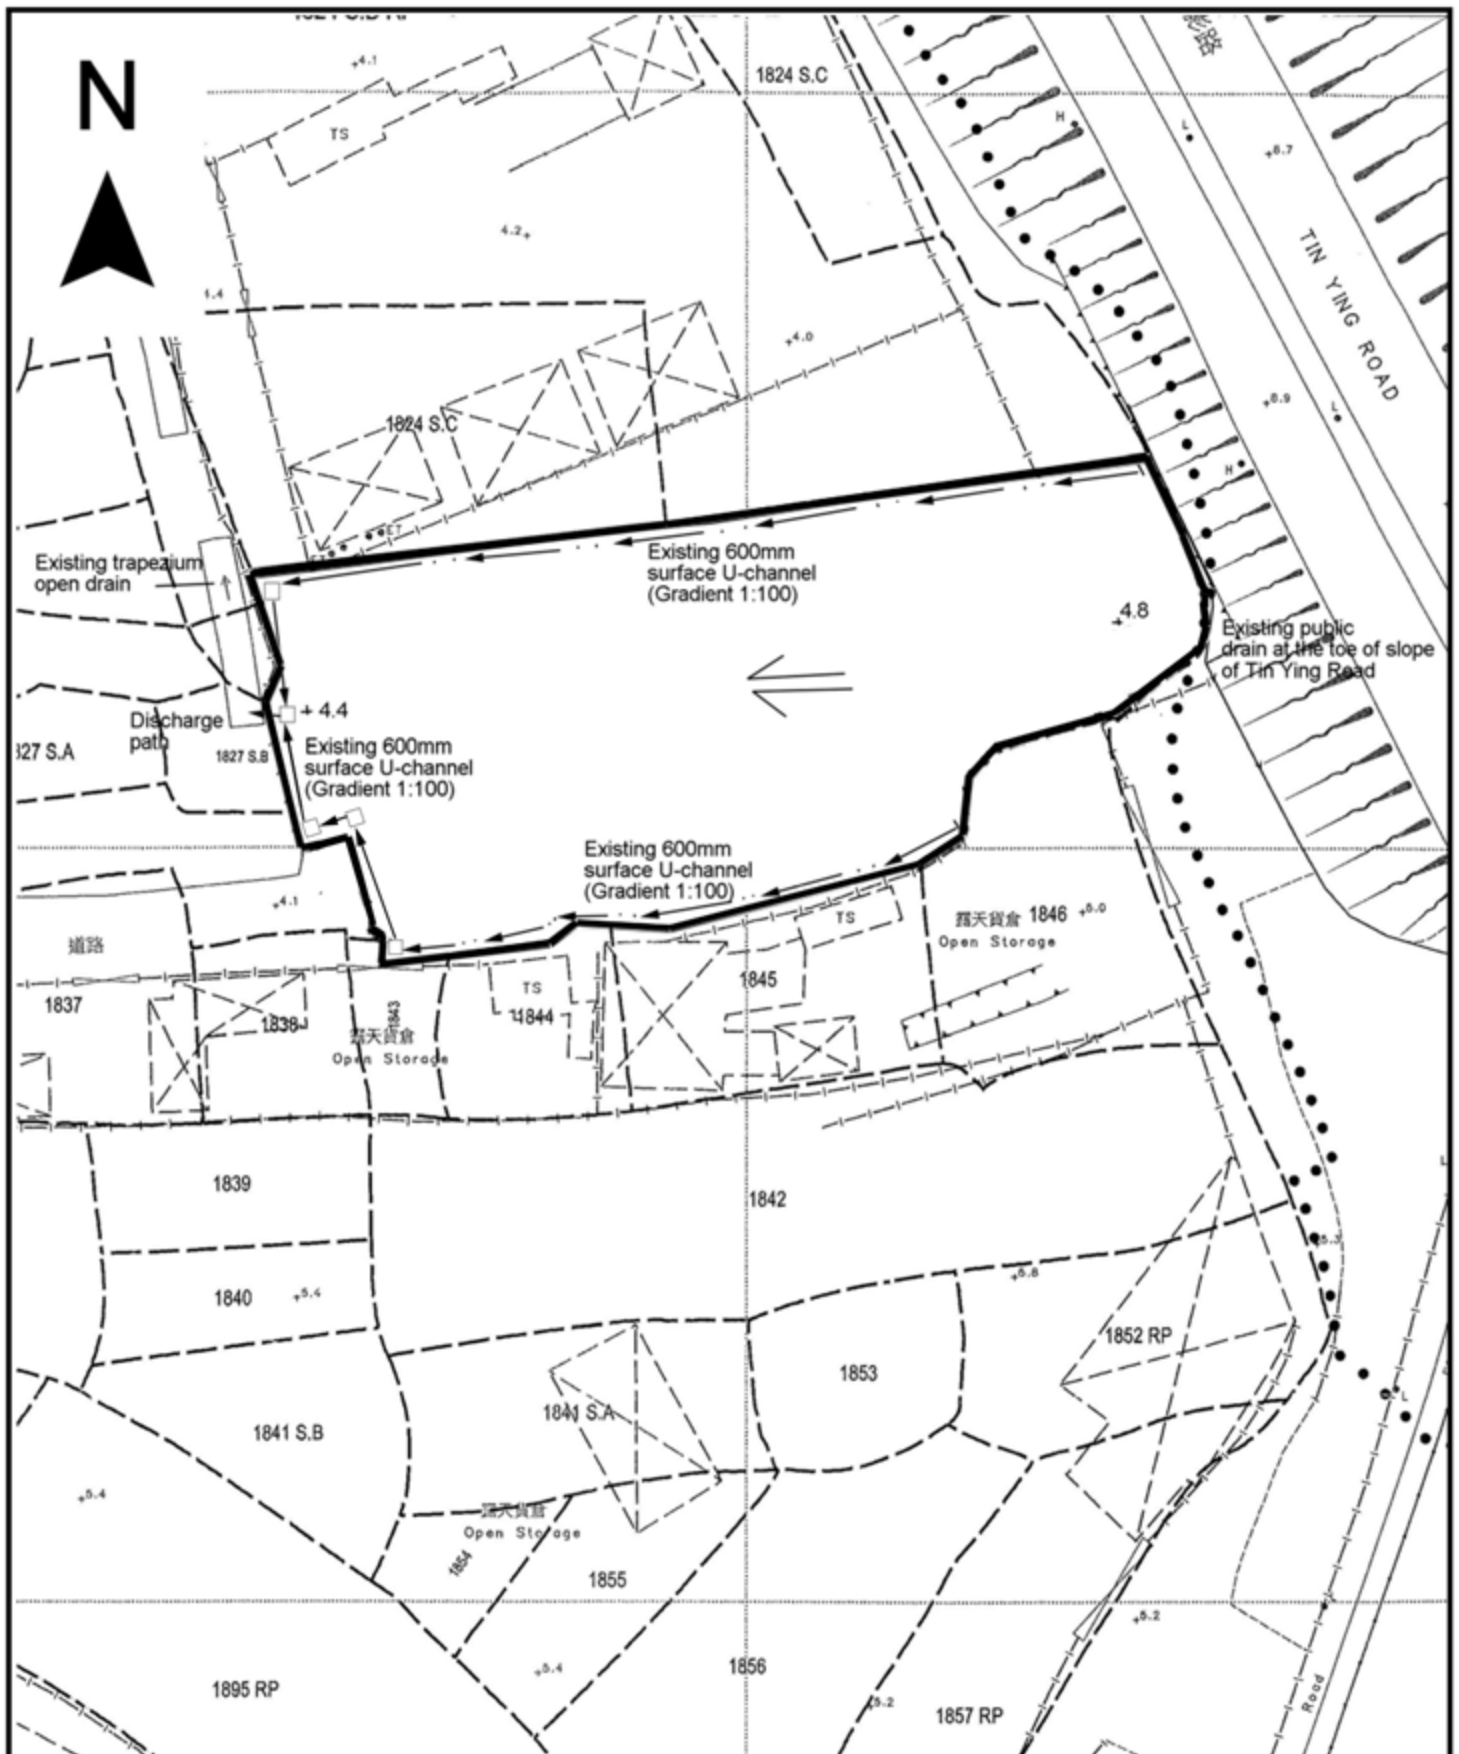

<p>Project 項目名稱: Temporary Warehouse for Storage of Spare Parts and Adblue for a Period of 3 Years at Lots 1827 S.B (Part), 1827 S.B ss.1, 1828 (Part), 1843 (Part), 1844 (Part), 1845 (Part), 1846 (Part), 1848, 1849 (Part), in D.D. 125 and Adjoining Government Land, Ha Tsuen, Yuen Long, N.T.</p>	<p>Drawing Title 圖目: As-built Drainage Plan</p> <p>Drawing No. 圖號: Figure 4</p>	<p>Remarks 備註: +4.8 Level (in mPD) Flow of surface runoff Catchpit</p> <p>Scale 比例: 11000</p>
--	---	---