


Project 項目名稱:
Temporary Logistics Centre for a Period of 3 Years at Lots 31 RP (Part) & 32 RP in D.D.128 & Lots 2433 (Part), 2436 (Part), 2437 (Part), 2438 S.B (Part), 2958 (Part), 2959 (Part), 2960 (Part), 2961 S.A ss.1 (Part), 2961 RP (Part), 2962 (Part), 2963 (Part), 2964, 2965, 2966, 2967 S.A, 2967 RP, 2968 S.A, 2968 S.B, 2969, 2970, 2971, 2972, 2973, 2974 (Part), 2975 S.A (Part), 2975 S.B (Part), 2976 (Part), 2977 S.A (Part), 2977 S.B (Part), 2983 RP (Part), 2984, 2985, 2986, 2987, 2988 (Part), 2989 RP (Part), 2991 RP (Part), 3085 (Part), 3086 (Part), 3087 (Part) in D.D.129 and Adjoining Government Land, Lau Fau Shan, Yuen Long, N.T.

Drawing Title 圖目:
Site Plan


Drawing No. 圖號:
Figure 1

Remarks 備註:

Scale 比例:
1:2000

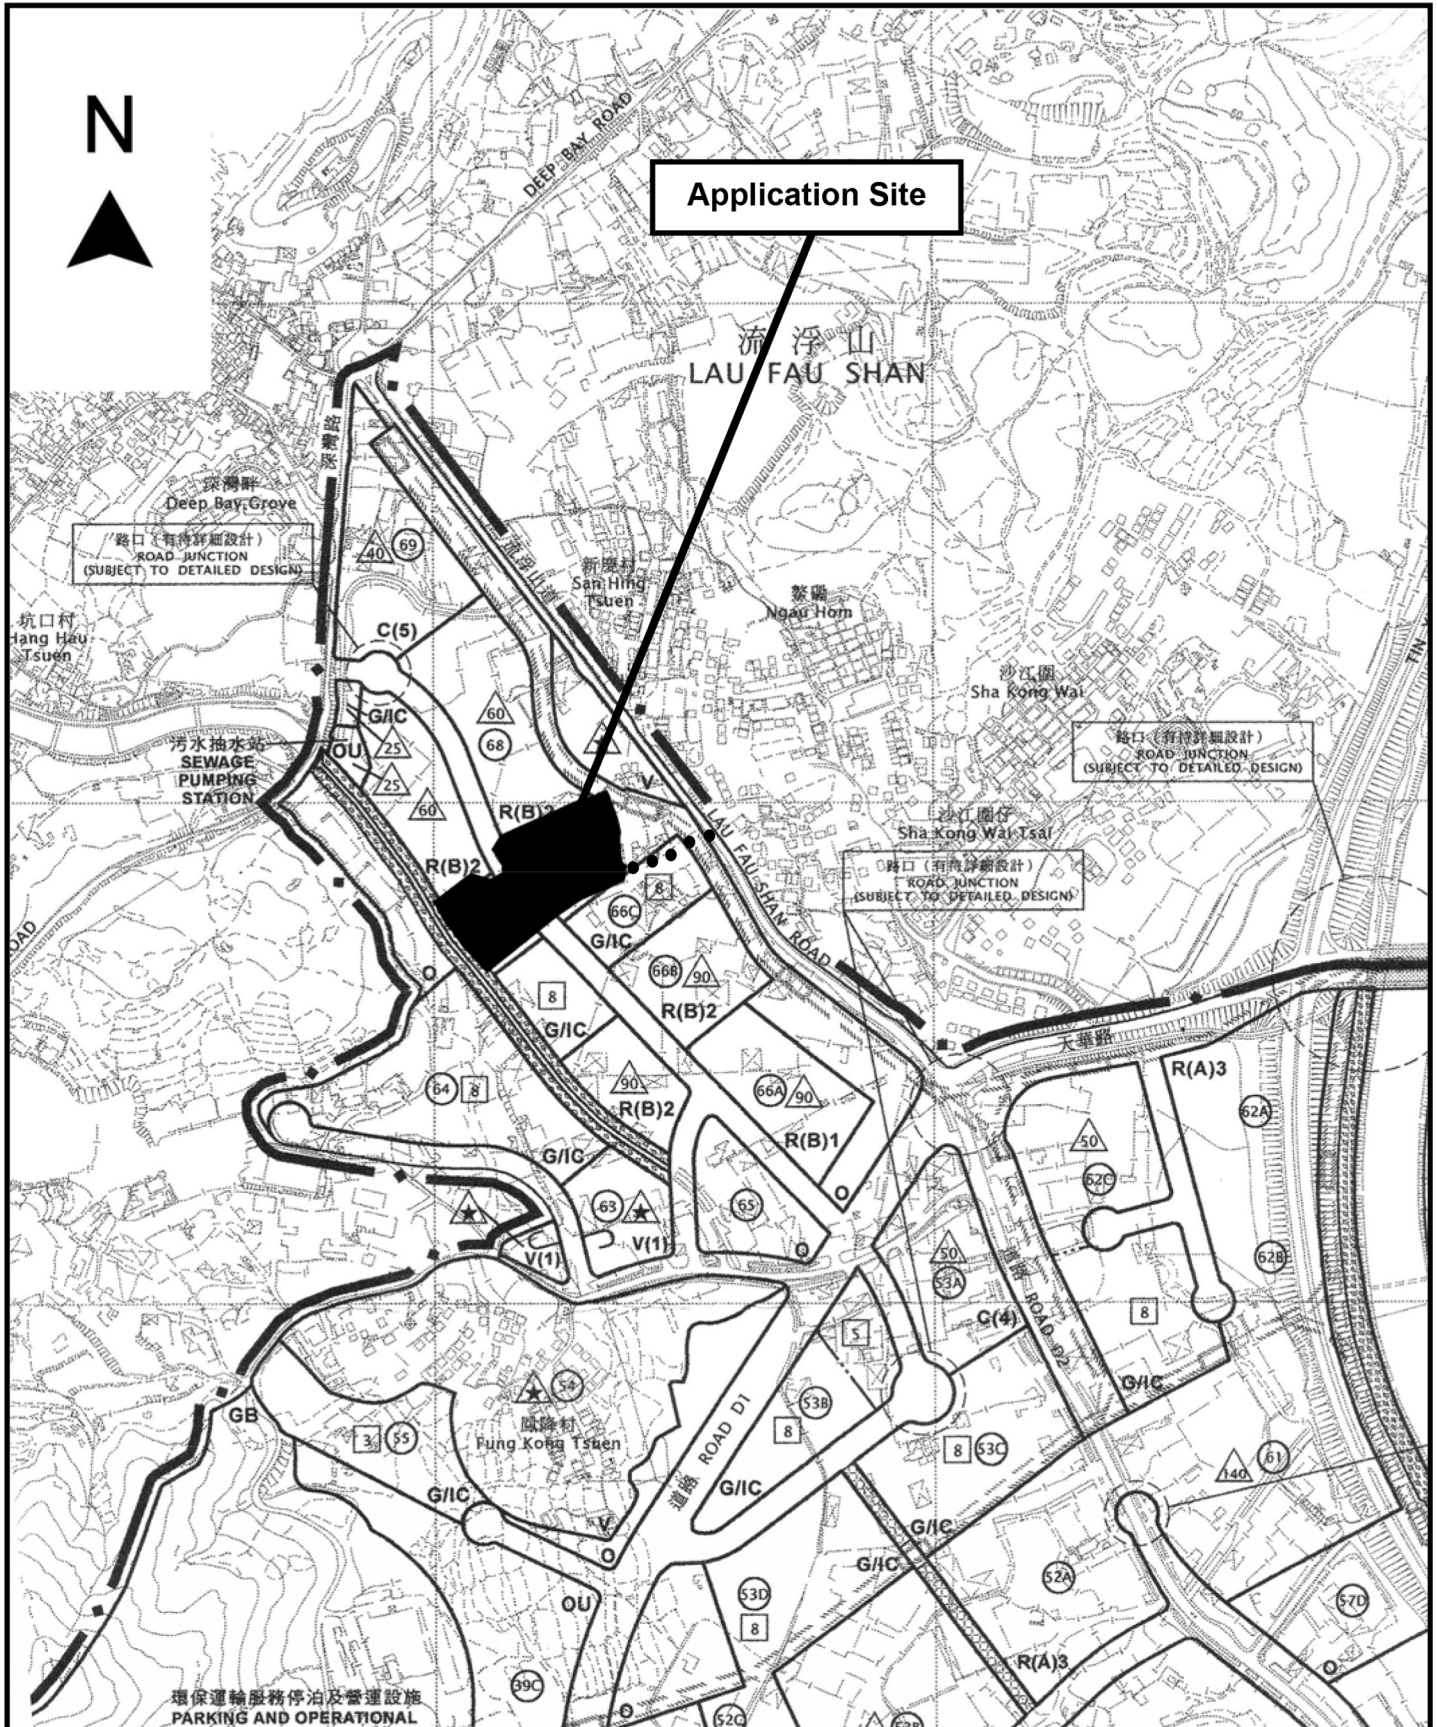

<p>Project 項目名稱: Temporary Logistics Centre for a Period of 3 Years at Lots 31 RP (Part) & 32 RP in D.D.128 & Lots 2433 (Part), 2436 (Part), 2437 (Part), 2438 S.B (Part), 2958 (Part), 2959 (Part), 2960 (Part), 2961 S.A ss.1 (Part), 2961 RP (Part), 2962 (Part), 2963 (Part), 2964, 2965, 2966, 2967 S.A, 2967 RP, 2968 S.A, 2968 S.B, 2969, 2970, 2971, 2972, 2973, 2974 (Part), 2975 S.A (Part), 2975 S.B (Part), 2976 (Part), 2977 S.A (Part), 2977 S.B (Part), 2983 RP (Part), 2984, 2985, 2986, 2987, 2988 (Part), 2989 RP (Part), 2991 RP (Part), 3085 (Part), 3086 (Part), 3087 (Part) in D.D.129 and Adjoining Government Land, Lau Fau Shan, Yuen Long, N.T.</p>	<p>Drawing Title 圖目: Location Plan</p> <p>Drawing No. 圖號: Figure 2</p>	<p>Remarks 備註: ●●● Vehicular access leading from Lau Fau Shan Road</p> <p>Scale 比例: 1:7500</p>
---	--	--

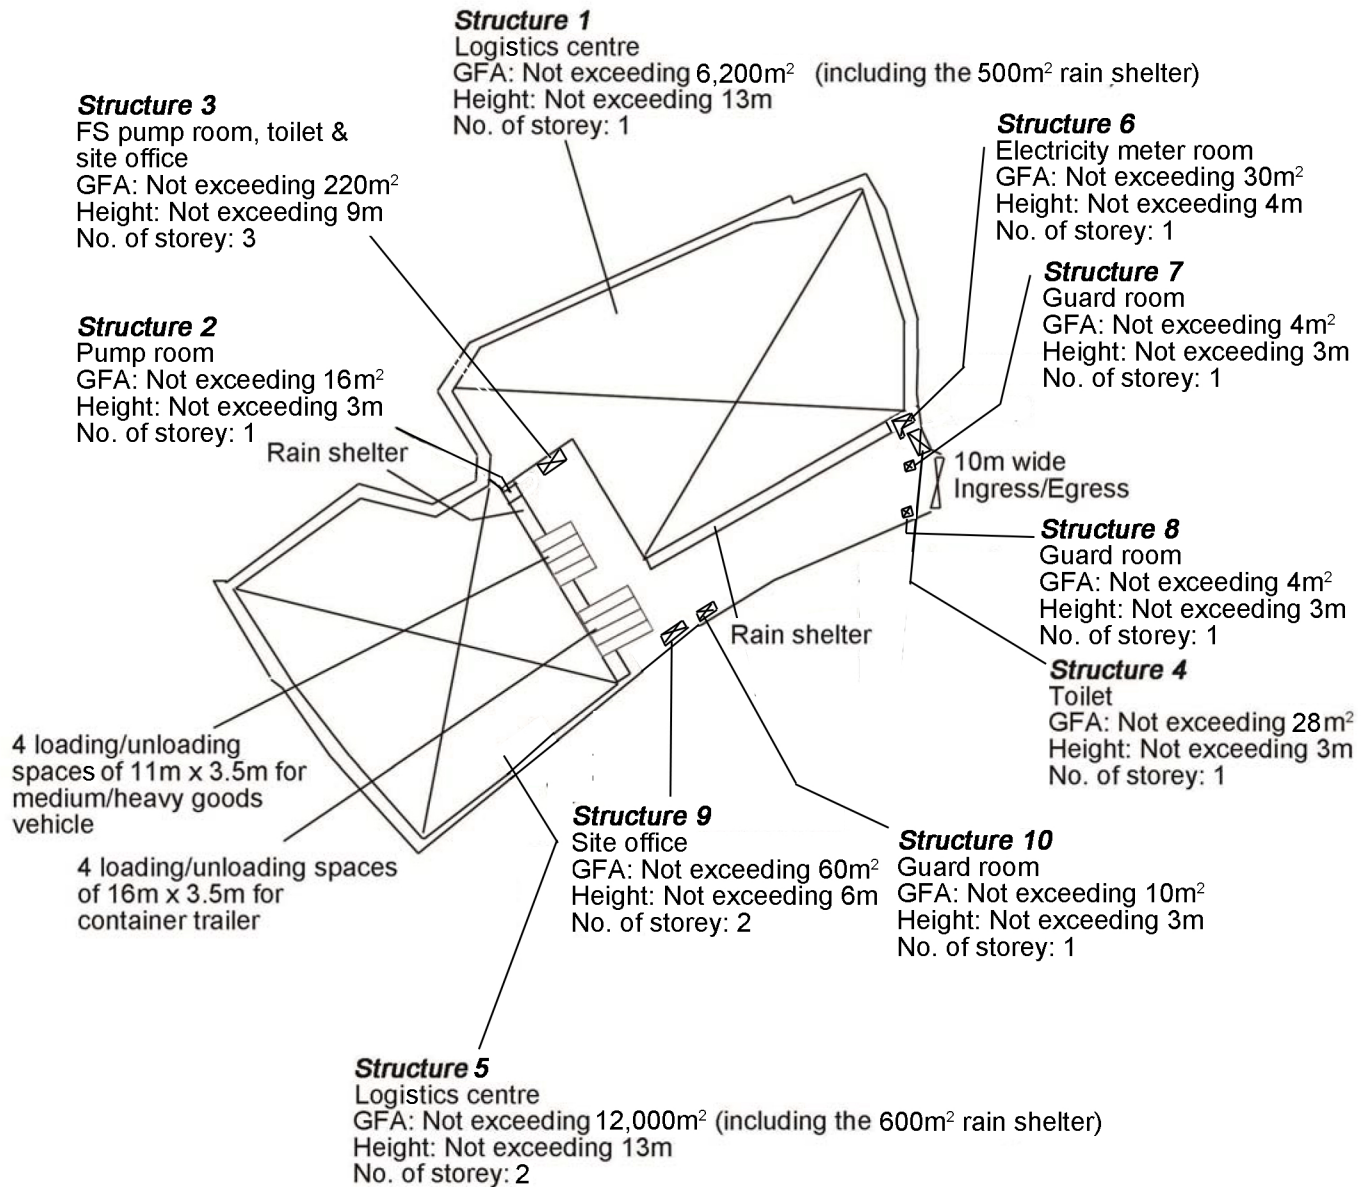

Project 項目名稱:

Temporary Logistics Centre for a Period of 3 Years at Lots 31 RP (Part) & 32 RP in D.D.128 & Lots 2433 (Part), 2436 (Part), 2437 (Part), 2438 S.B (Part), 2958 (Part), 2959 (Part), 2960 (Part), 2961 S.A ss.1 (Part), 2961 RP (Part), 2962 (Part), 2963 (Part), 2964, 2965, 2966, 2967 S.A, 2967 RP, 2968 S.A, 2968 S.B, 2969, 2970, 2971, 2972, 2973, 2974 (Part), 2975 S.A (Part), 2975 S.B (Part), 2976 (Part), 2977 S.A (Part), 2977 S.B (Part), 2983 RP (Part), 2984, 2985, 2986, 2987, 2988 (Part), 2989 RP (Part), 2991 RP (Part), 3085 (Part), 3086 (Part), 3087 (Part) in D.D.129 and Adjoining Government Land, Lau Fau Shan, Yuen Long, N.T.

Drawing Title 圖目:

Proposed Layout Plan



Drawing No. 圖號:

Figure 3

Remarks 備註:

Scale 比例:

1:2000

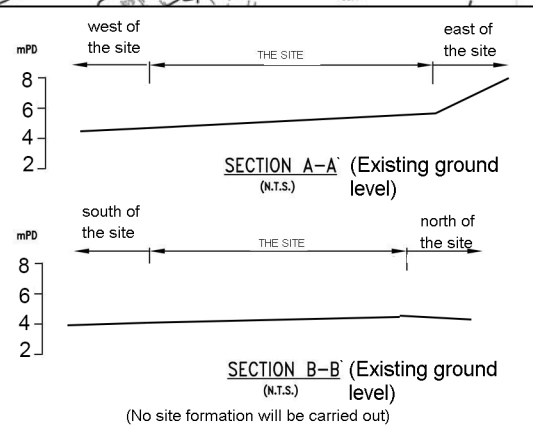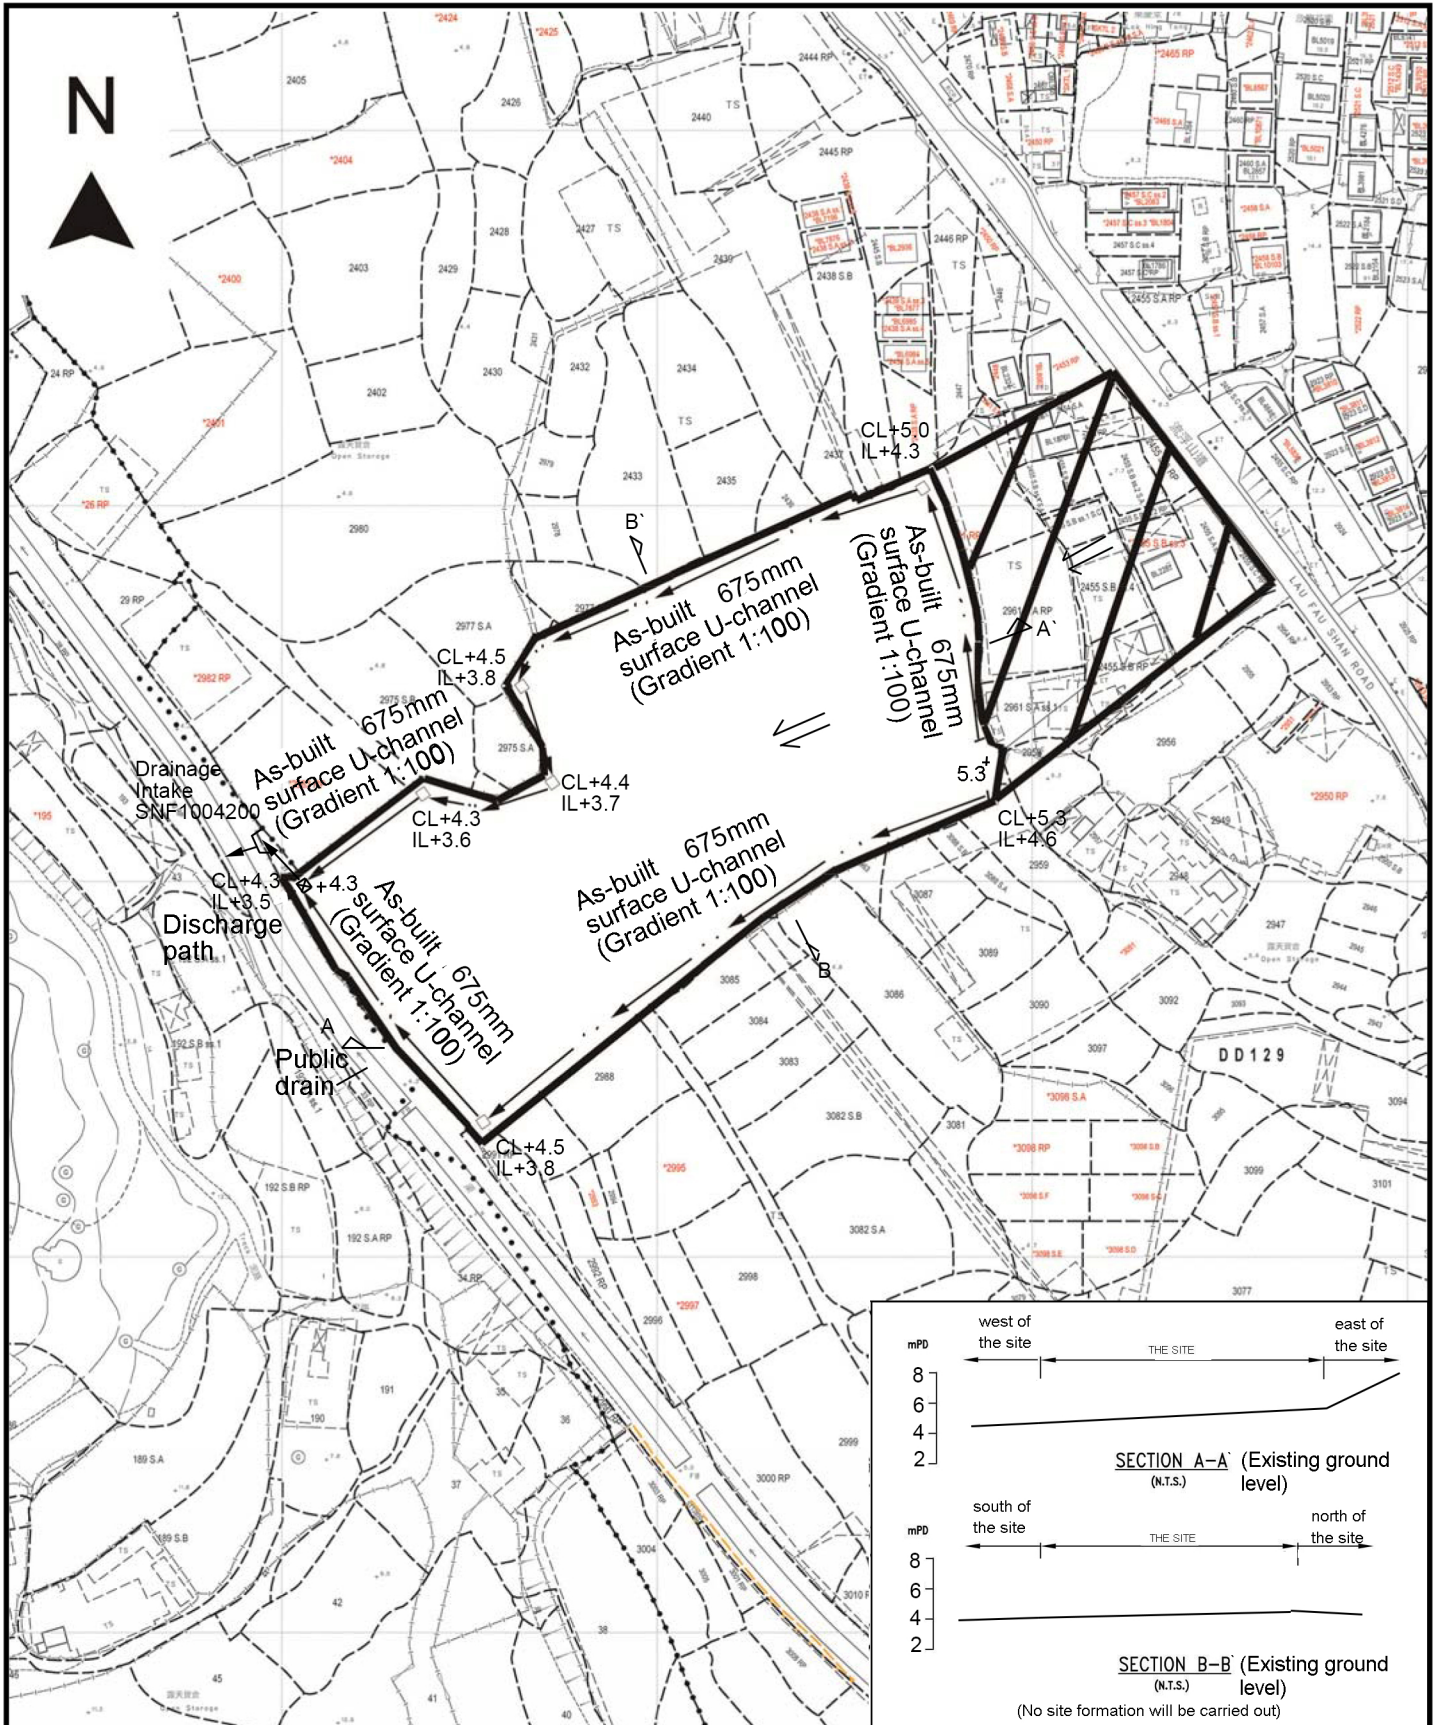

(No site formation will be carried out)

Project 項目名稱:

Temporary Logistics Centre for a Period of 3 Years at Lots 31 RP (Part) & 32 RP in D.D.128 & Lots 2433 (Part), 2436 (Part), 2437 (Part), 2438 S.B (Part), 2958 (Part), 2959 (Part), 2960 (Part), 2961 S.A ss.1 (Part), 2961 RP (Part), 2962 (Part), 2963 (Part), 2964, 2965, 2966, 2967 S.A, 2967 RP, 2968 S.A, 2968 S.B, 2969, 2970, 2971, 2972, 2973, 2974 (Part), 2975 S.A (Part), 2975 S.B (Part), 2976 (Part), 2977 S.A (Part), 2977 S.B (Part), 2983 RP (Part), 2984, 2985, 2986, 2987, 2988 (Part), 2989 RP (Part), 2991 RP (Part), 3085 (Part), 3086 (Part), 3087 (Part) in D.D.129 and Adjoining Government Land, Lau Fau Shan, Yuen Long, N.T.

Drawing Title 圖目:

As-built Drainage Plan

Drawing No. 圖號:

Figure 4

Remarks 備註:

- + 4.3 Level (in mPD)
- ☒ Proposed catchpit w/ sandtrap
- ☐ Proposed catchpit

⇐ Flow of surface runoff

▣ External catchment

Scale 比例:

1:2000