


<p>Project 項目名稱:</p> <p>Temporary Shop and Services (Fresh Provision Shop) for a Period of 3 Years at Lot 1315 RP (Part) in D.D. 124 and Adjoining Government Land, San Sang San Tsuen, Yuen Long, N.T.</p>	<p>Drawing Title 圖目:</p> <p>Location Plan</p>	<p>Remarks 備註:</p> <p>● ● ● Vehicular access leading from Tin Ha Road</p>
	<p>Drawing No. 圖號:</p> <p>Figure 2</p>	<p>Scale 比例:</p> <p>1:7500</p>




Structure 1

Shop & service (Fresh provisions shop)
 GFA: Not exceeding 310m²
 Height: Not exceeding 6.5m
 No. of storey: 1

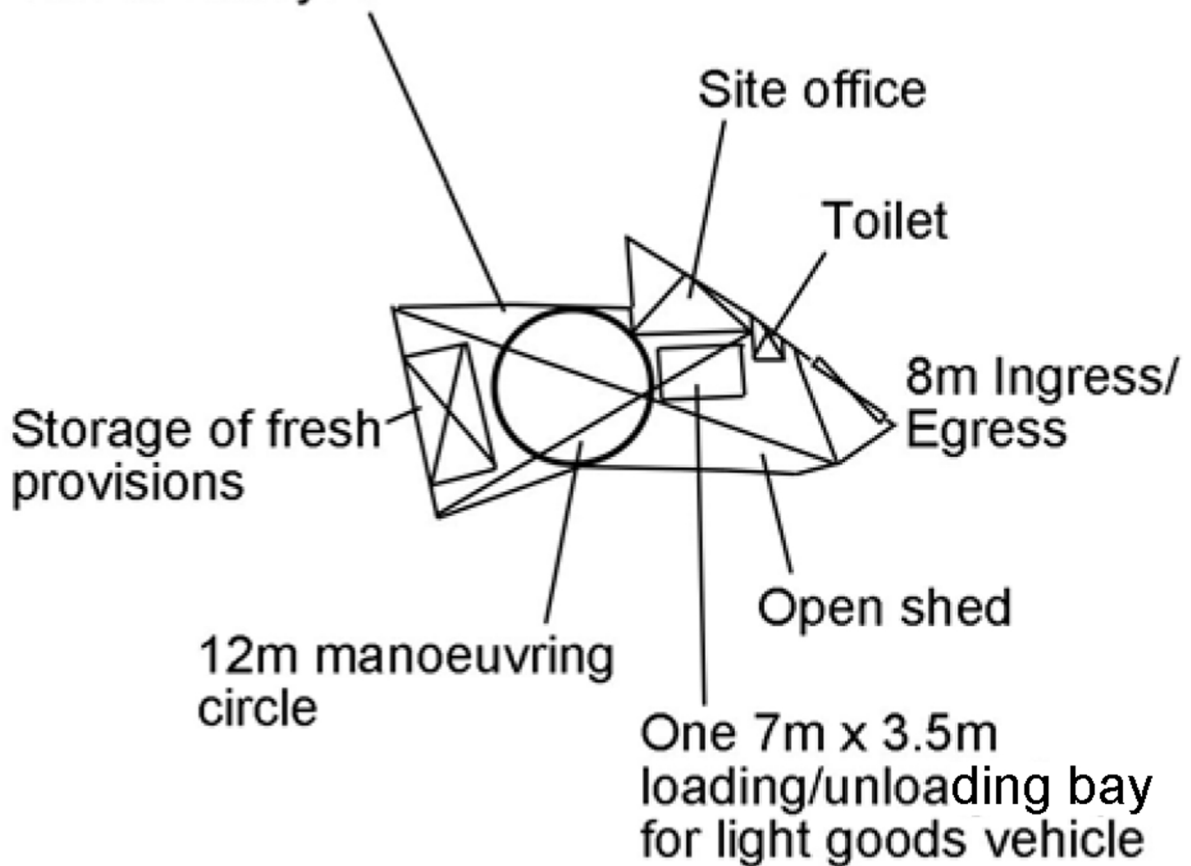

Project 項目名稱: Temporary Shop and Services (Fresh Provision Shop) for a Period of 3 Years at Lot 1315 RP (Part) in D.D. 124 and Adjoining Government Land, San Sang San Tsuen, Yuen Long, N.T.	Drawing Title 圖目: Proposed Layout Plan	Remarks 備註: Scale 比例: 1:500
	Drawing No. 圖號: Figure 3	

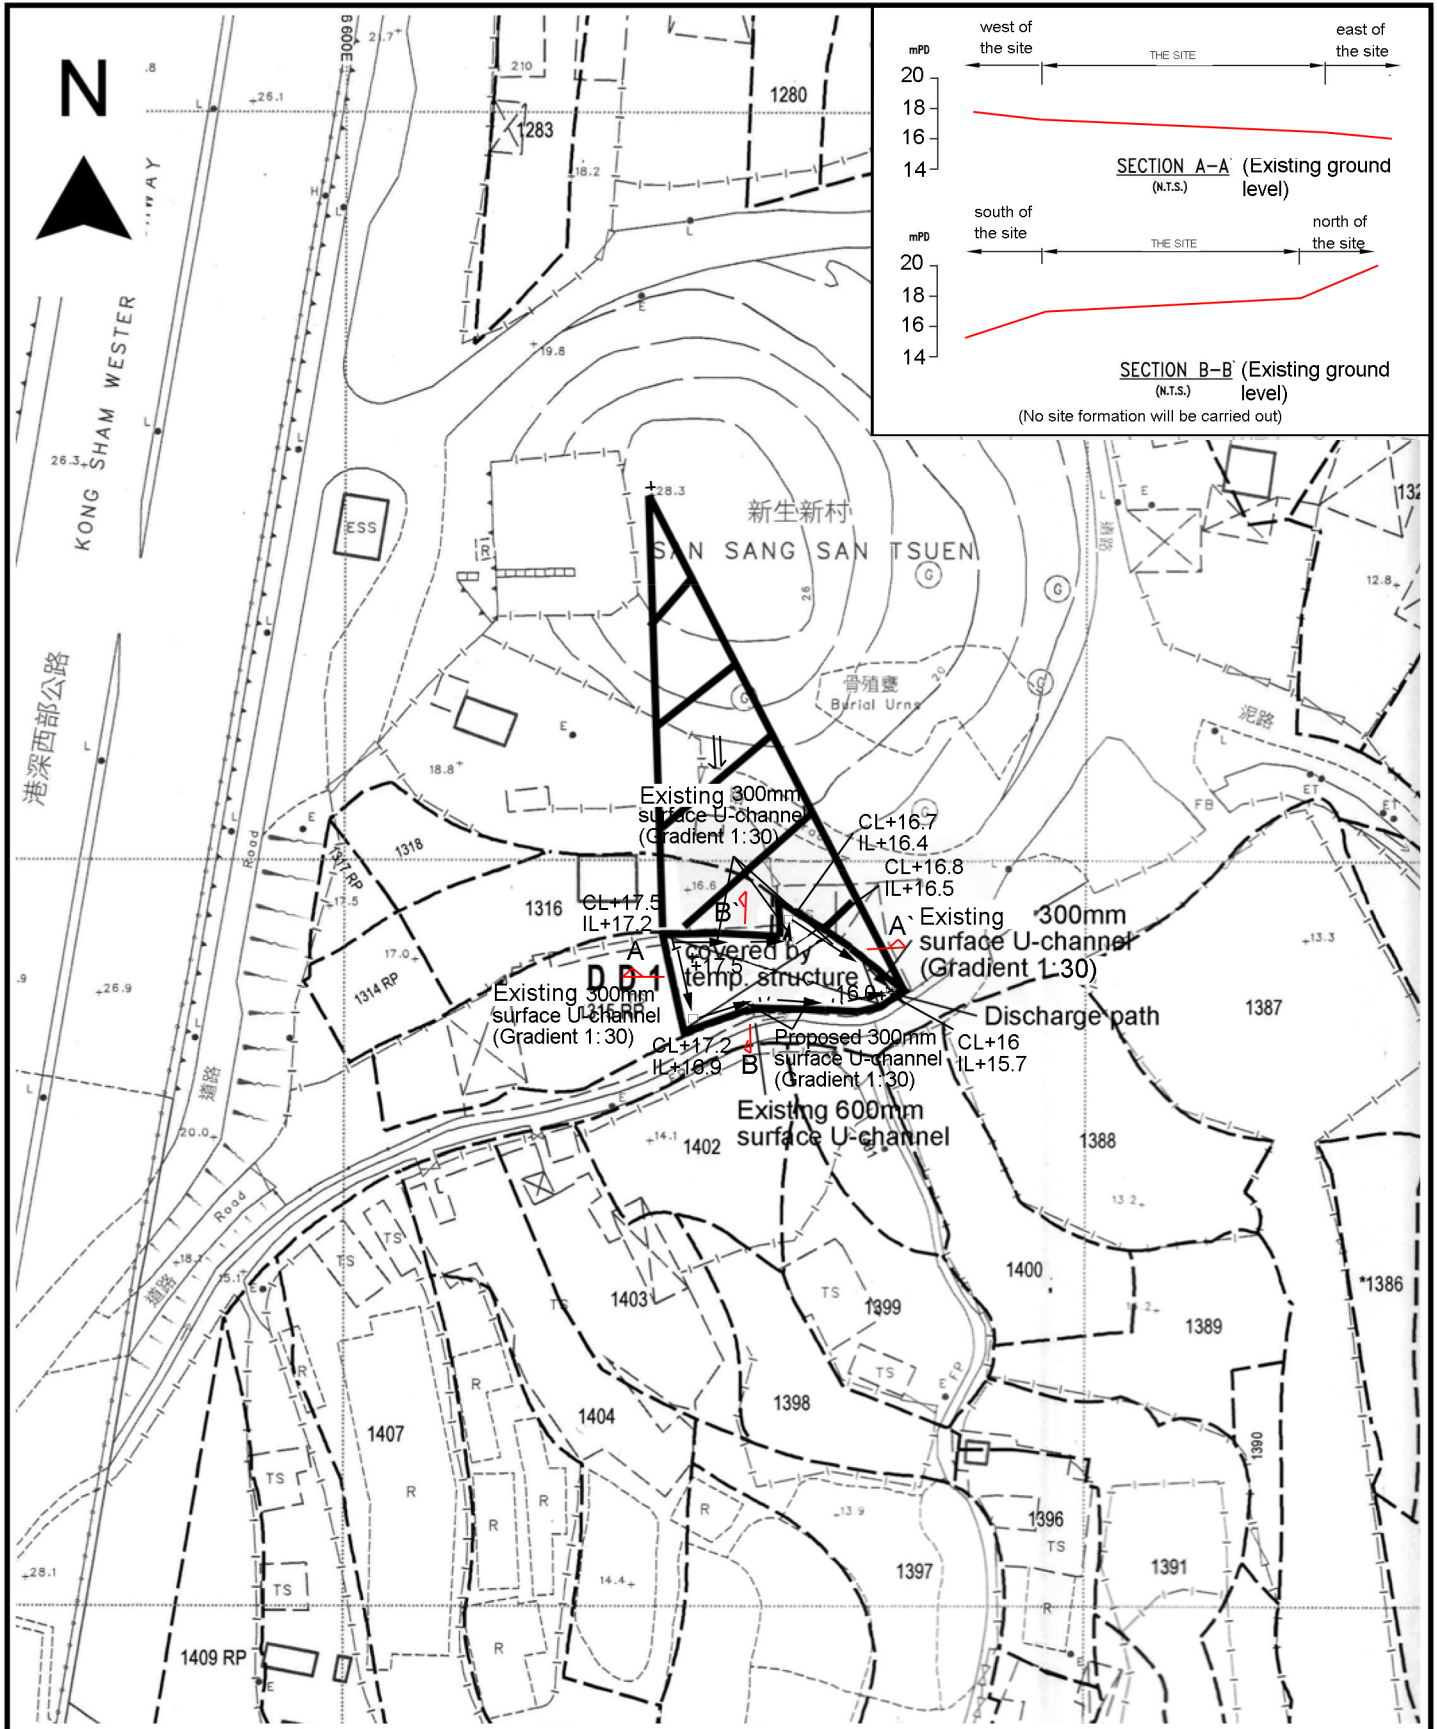

Project 項目名稱:

Temporary Shop and Services (Fresh Provision Shop) for a Period of 3 Years at Lot 1315 RP (Part) in D.D. 124 and Adjoining Government Land, San Sang San Tsuen, Yuen Long, N.T.

Drawing Title 圖目:

As-built Drainage Plan

Remarks 備註:

+28.3 Level (in mPD)

← Flow of surface runoff

☒ Catchpit with sand trap

☐ Existing catchpit

▨ External catchment

Drawing No. 圖號:

Figure 4

Scale 比例:

1:1000