


<p>Project 項目名稱:          Temporary Open Storage of Recyclable Materials (including Metal and Plastic) &amp; Construction Materials and Warehouses for Storage of Construction Materials for a Period of 3 Years at Lots 280 (Part), 281 (Part) &amp; 681 (Part) in D.D.125, San Wai, Ha Tsuen, Yuen Long, N.T.</p>	<p>Drawing Title 圖目:  <b>Site Plan</b></p> <p>Drawing No. 圖號:  <b>Figure 1</b></p>	<p>Remarks 備註:</p> <p>Scale 比例:          1:1000</p>
---	--	---



<p>Project 項目名稱:</p> <p>Temporary Open Storage of Recyclable Materials (including Metal and Plastic) &amp; Construction Materials and Warehouses for Storage of Construction Materials for a Period of 3 Years at Lots 280 (Part), 281 (Part) &amp; 681 (Part) in D.D.125, San Wai, Ha Tsuen, Yuen Long, N.T.</p>	<p>Drawing Title 圖目:</p> <p>Location Plan</p> <p>Drawing No. 圖號:</p> <p>Figure 2</p>	<p>Remarks 備註:</p> <ul style="list-style-type: none"> <li>••• Vehicular access leading from Kai Pak Ling Road</li> </ul> <p>Scale 比例:</p> <p>1:7500</p>
---	--	---

N

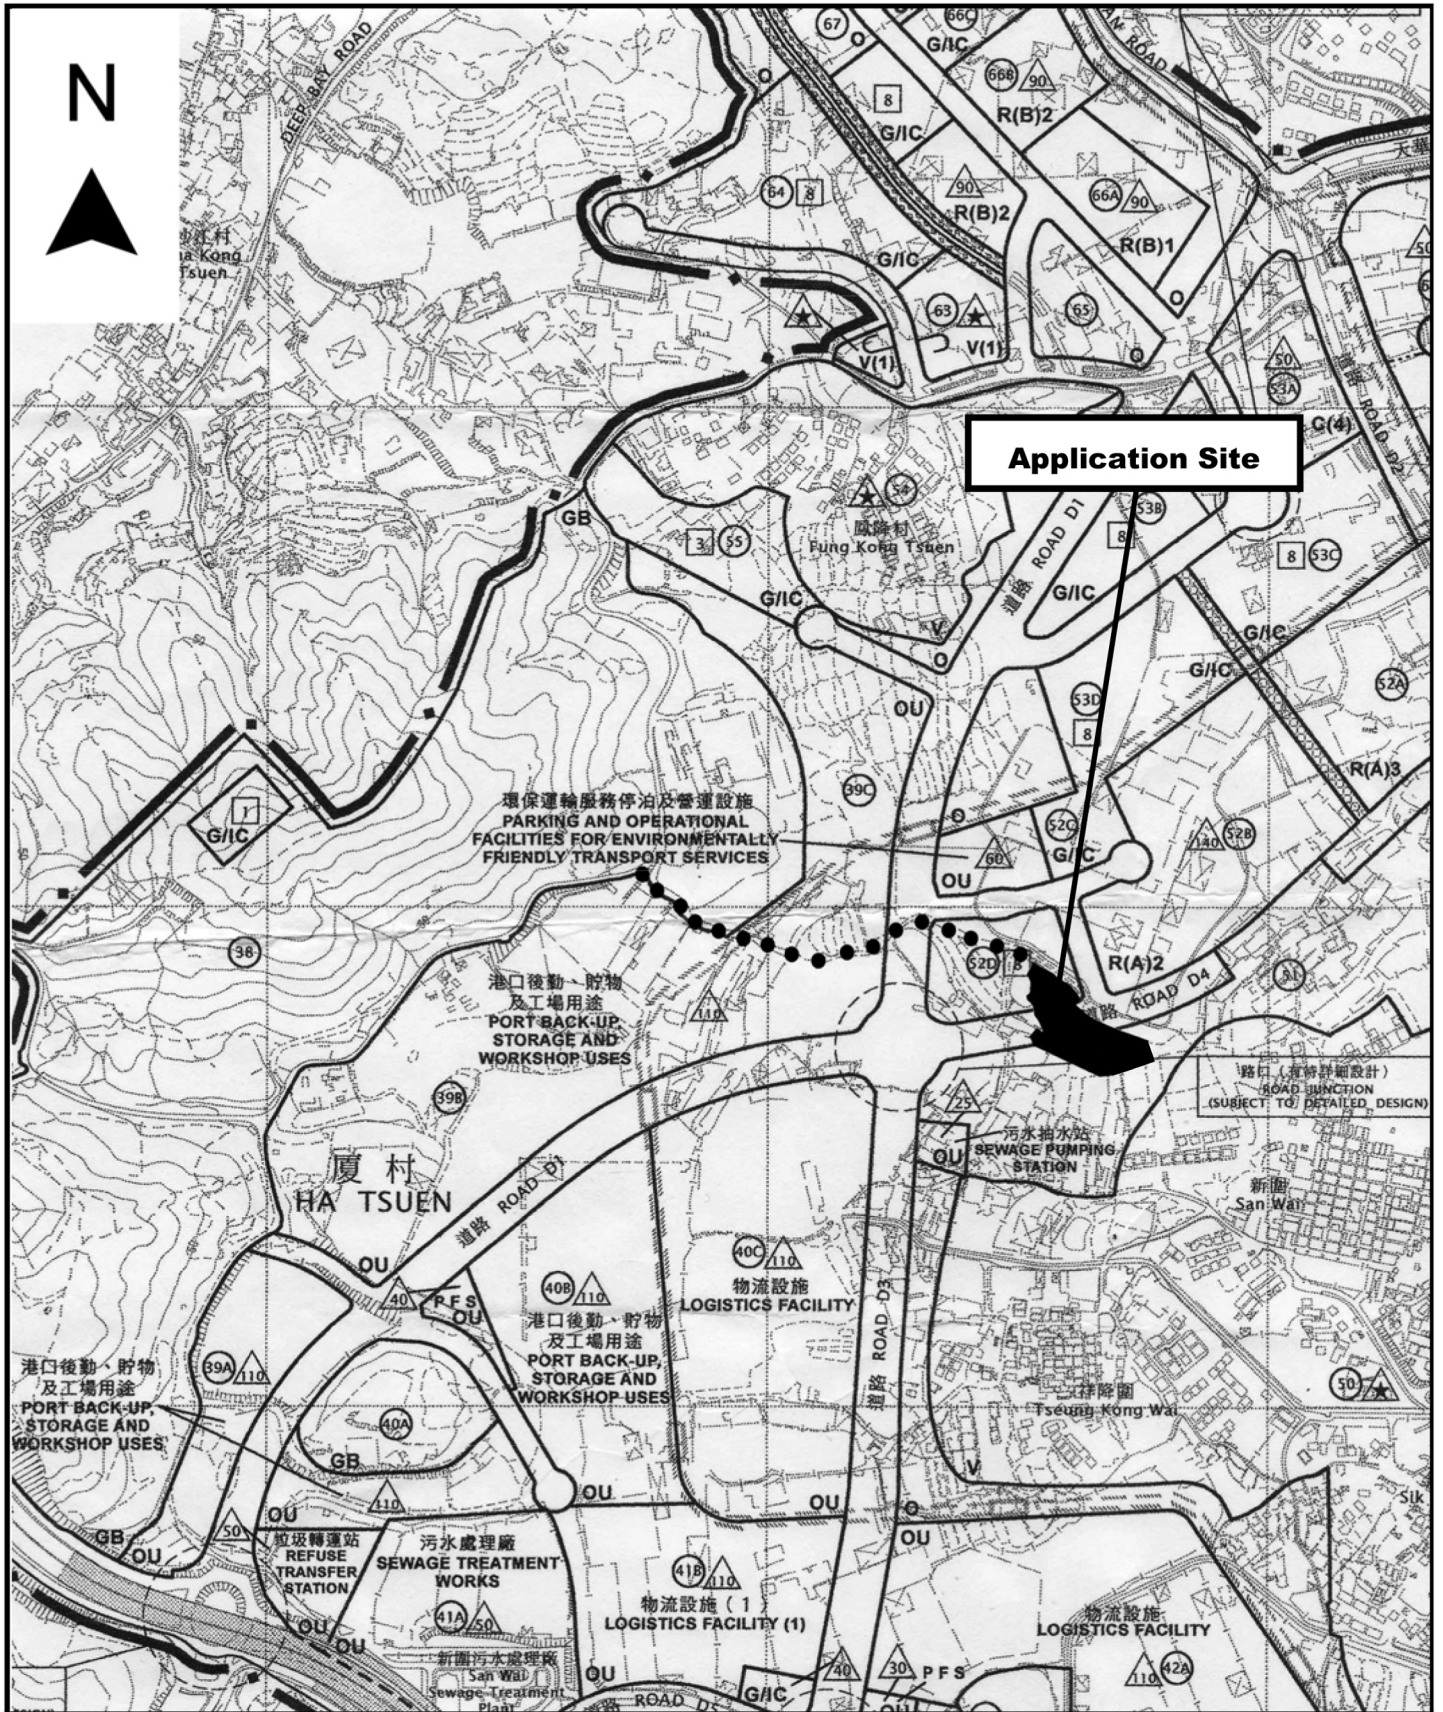

**Structure 1**

Site office  
GFA: Not exceeding 40m<sup>2</sup>  
Height: Not exceeding 6m  
No. of storey: 2

7m Ingress/  
Egress

7m Ingress/  
Egress

Open storage of  
recyclable materials  
(metal and plastic)  
(About 2,560m<sup>2</sup>)

20m diameter  
manoeuvring  
circle

Open storage of  
construction materials  
(About 2,150m<sup>2</sup>)

One 11m x 3.5m loading/  
unloading bay for medium  
goods vehicle

**Structure 2**

Warehouse for storage  
of construction materials  
GFA: Not exceeding 228m<sup>2</sup>  
Height: Not exceeding 8m  
No. of storey: 1

**Structure 3**

Warehouse for storage  
of construction materials  
GFA: Not exceeding 228m<sup>2</sup>  
Height: Not exceeding 8m  
No. of storey: 1

**Structure 4**

Warehouse for storage  
of construction materials  
GFA: Not exceeding 228m<sup>2</sup>  
Height: Not exceeding 8m  
No. of storey: 1

Project 項目名稱:

Temporary Open Storage of Recyclable Materials (including Metal and Plastic) & Construction Materials and Warehouses for Storage of Construction Materials for a Period of 3 Years at Lots 280 (Part), 281 (Part) & 681 (Part) in D.D.125, San Wai, Ha Tsuen, Yuen Long, N.T.

Drawing Title 圖目:

Proposed Layout Plan


Remarks 備註:

Drawing No. 圖號:

Figure 3

Scale 比例:

1:1000

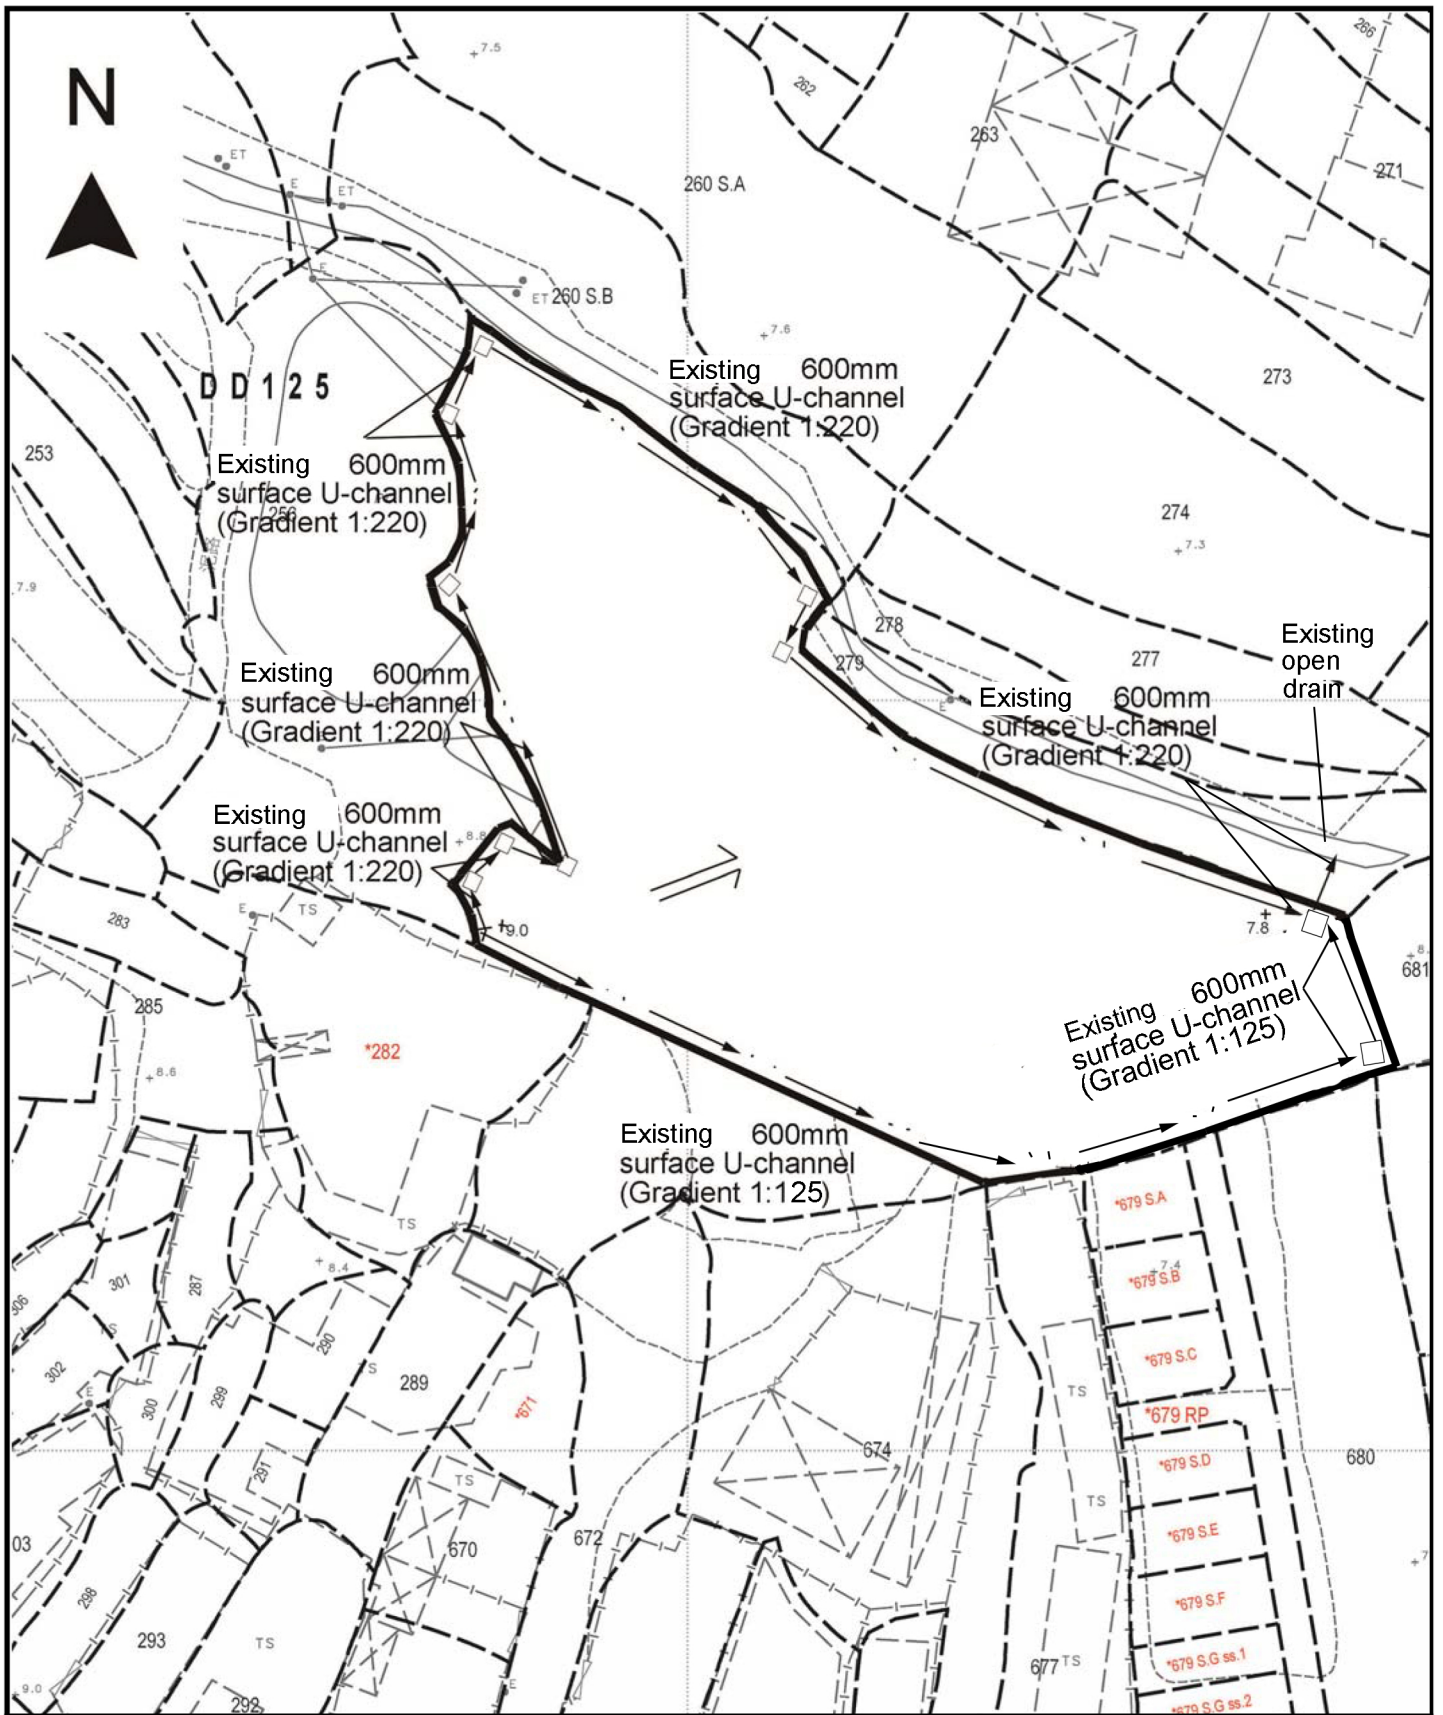

<p>Project 項目名稱:  <b>Temporary Open Storage of Recyclable Materials (including Metal and Plastic) &amp; Construction Materials and Warehouses for Storage of Construction Materials for a Period of 3 Years at Lots 280 (Part), 281 (Part) &amp; 681 (Part) in D.D.125, San Wai, Ha Tsuen, Yuen Long, N.T.</b></p>	<p>Drawing Title 圖目:  <b>As-built Drainage Plan</b></p>	<p>Remarks 備註:  <input type="checkbox"/> Existing catchpit          +7.8 Level (in mPD)   Flow of surface runoff</p>
	<p>Drawing No. 圖號:  <b>Figure 4</b></p>	<p>Scale 比例:  <b>1:1000</b></p>